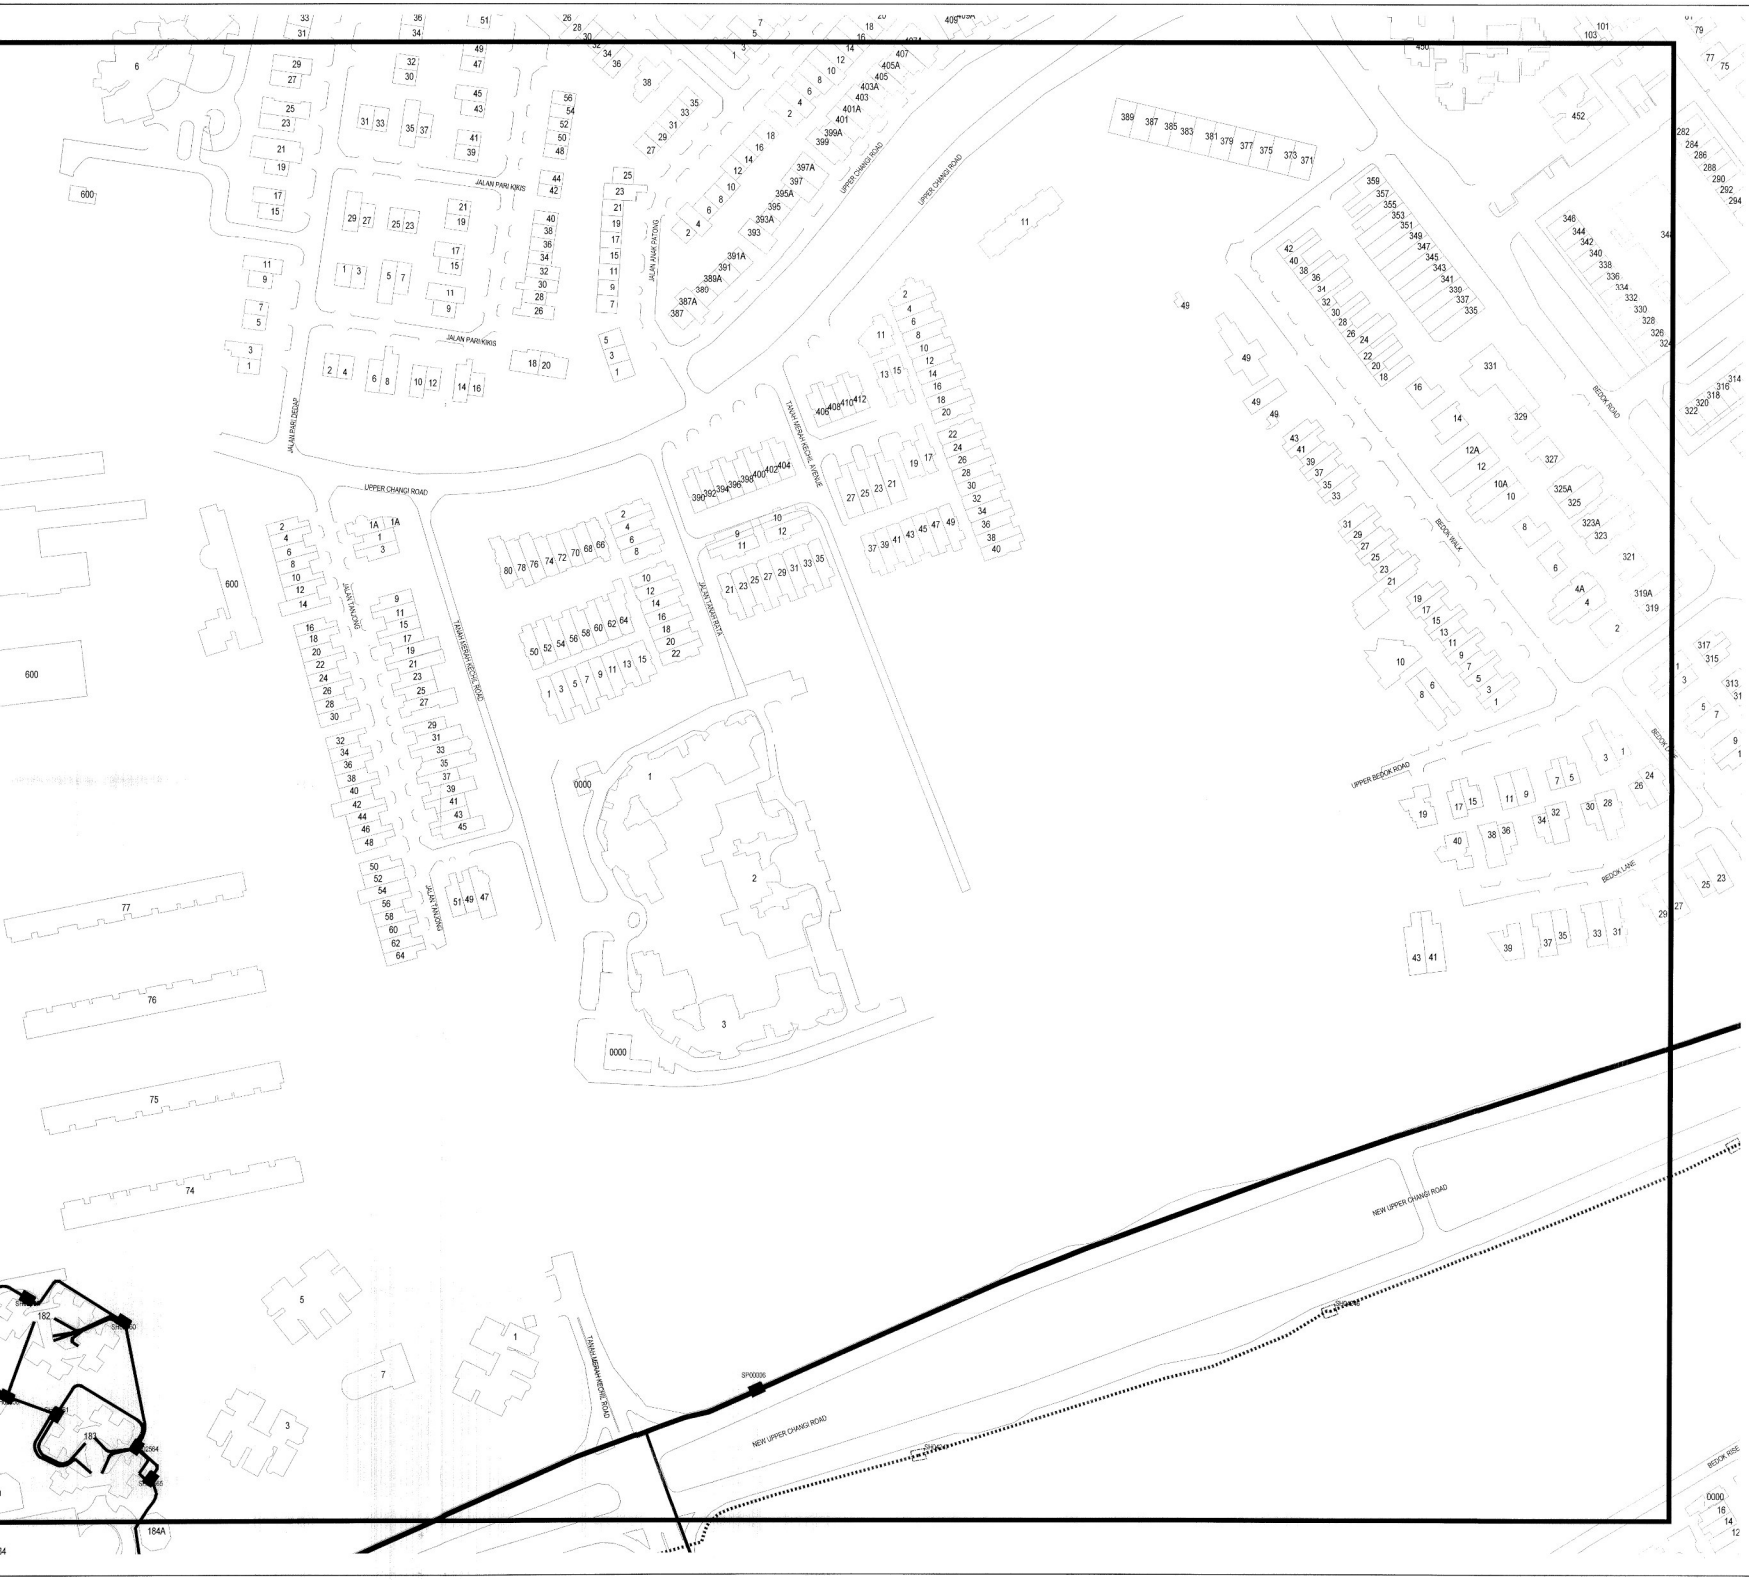

StarHub Ltd
No. 3 Tai Seng Drive,
#04-00, Da Vinci Building
Singapore 535216
Tel: (65) 68256100 Fax: (65) 68217000

Disclaimer:

1. These plans/drawings are confidential and must not be complilled or disclosed to any other party.
2. These plans/drawings are intended as guides only. StarHub makes no warranty as to their accuracy. StarHub is not liable for any variances that may exist between the actual location of any pipes, ducts, cables and other infrastructure and as shown on these plans/drawings. You must carry out your own independent checks and test. Release of these plans and drawings by StarHub in no way reduces your responsibility to carry out works with care and in accordance with all relevant laws, rules and regulations. StarHub Ltd will not be liable to you for any damage, loss, cost, expense, claims, actions or proceedings suffered by you arising from your use of the information contained herein. You will indemnify and hold StarHub Ltd harmless against any damage, loss, cost, expense, claims, actions or proceedings suffered by StarHub Ltd as a result of any damage to any underground plant arising from your works.
3. We and/or our licensors own these plans/drawings and all intellectual property rights associated therewith, you are not permitted to copy, reproduce, distribute or create derivative works from any part of these without written authorization from us and/or our licensors.
4. Please note that this plant map is only valid for six months from the date of purchase.
5. Please contact the Administrator for Sales of StarHub Plant Map at 6825 6374 for further clarification.

OUR REF: 2008/06/02-3

YOUR REF:

TITLE:
TANAH MERAH KECHIL RD

REQUESTED BY:
SINGAPORE LAND AUTHORITY

DATE OF PLOT & SIGNATURE:
12/06/2008

Area-In-Charge:
ROLAND LIM

Contact No:
9859 0844

Legend ORIGINAL

- **As-Built Manhole**
- **As-Built Pipeline**
- **Proposed Manhole**
- **Proposed Pipeline**

printed by: wdee